

TYP. SIDEWALK EDGE
 $1'' = 1'-0''$

6
2

TYP. BENCH SECTION

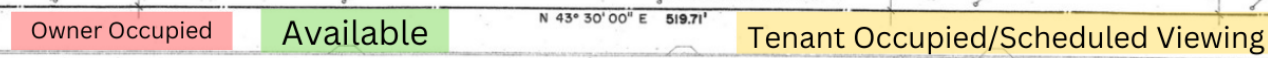

1. COORDINATE UTILITY SITE PLAN FOR ABOVE-GRADE DRAINAGE AND OUTDOOR LIGHTING. (SHEET 41)
2. CONTRACTOR TO PROVIDE 6 YELLOW STRIPES & HANDPAID GRAPHICS (CENTERED IN SPACE) @ PARKING AREAS.
3. CONTRACTOR TO MAINTAIN 1% SLOPE ON PARKING & DRIVES.
4. SIDEWALK ELEVATION @ BUILDING ENTRANCE TO BE 26.50.
5. SLOPE COURT-YARD GRADE EVENLY TO MEET GATCH BARRIS.


EXISTING SPOT ELEVATION

NEW SPOT ELEVATION

 $1^{\text{st}} = 30^{\circ} \text{ } 0^{\text{st}}$

PROJECT:	01-82
DATE:	24 JANUARY '82
DRAWN BY:	DA./AP.O
CHECKED BY:	



SHEET NO.

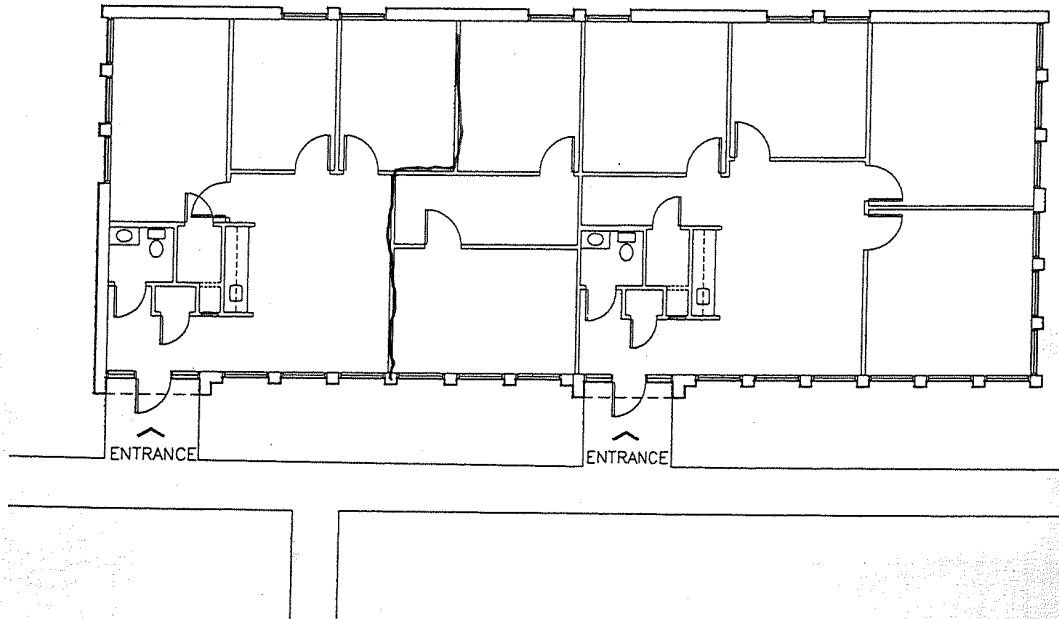

BUILDING G

2,624 SQ.FT.


0 1/16" 16'

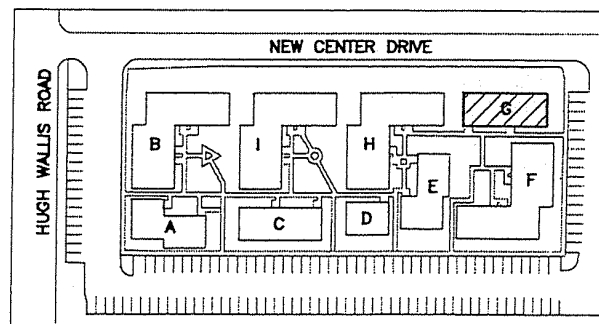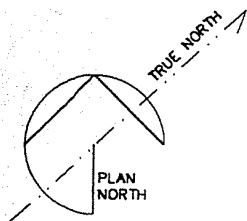

KEY PLAN

BUILDING G FLOOR PLAN



 <p>ZILER ARCHITECTS A PROFESSIONAL ARCHITECTURAL CORPORATION 101 CALICO BLVD LAFAYETTE, LOUISIANA 70503 337 269 6356 FAX 269 6360</p>	<p>RECORD DRAWINGS FOR:</p> <p>THE GARDENS</p> <p>1003 HUGH WALLIS ROAD LAFAYETTE, LOUISIANA</p>	<p>DATE ISSUED 10-12-06</p> <p>PROJECT NO. 2527</p> <p>SHEET NO. FP-G</p> <p>OF <u>9</u></p>
--	---	---

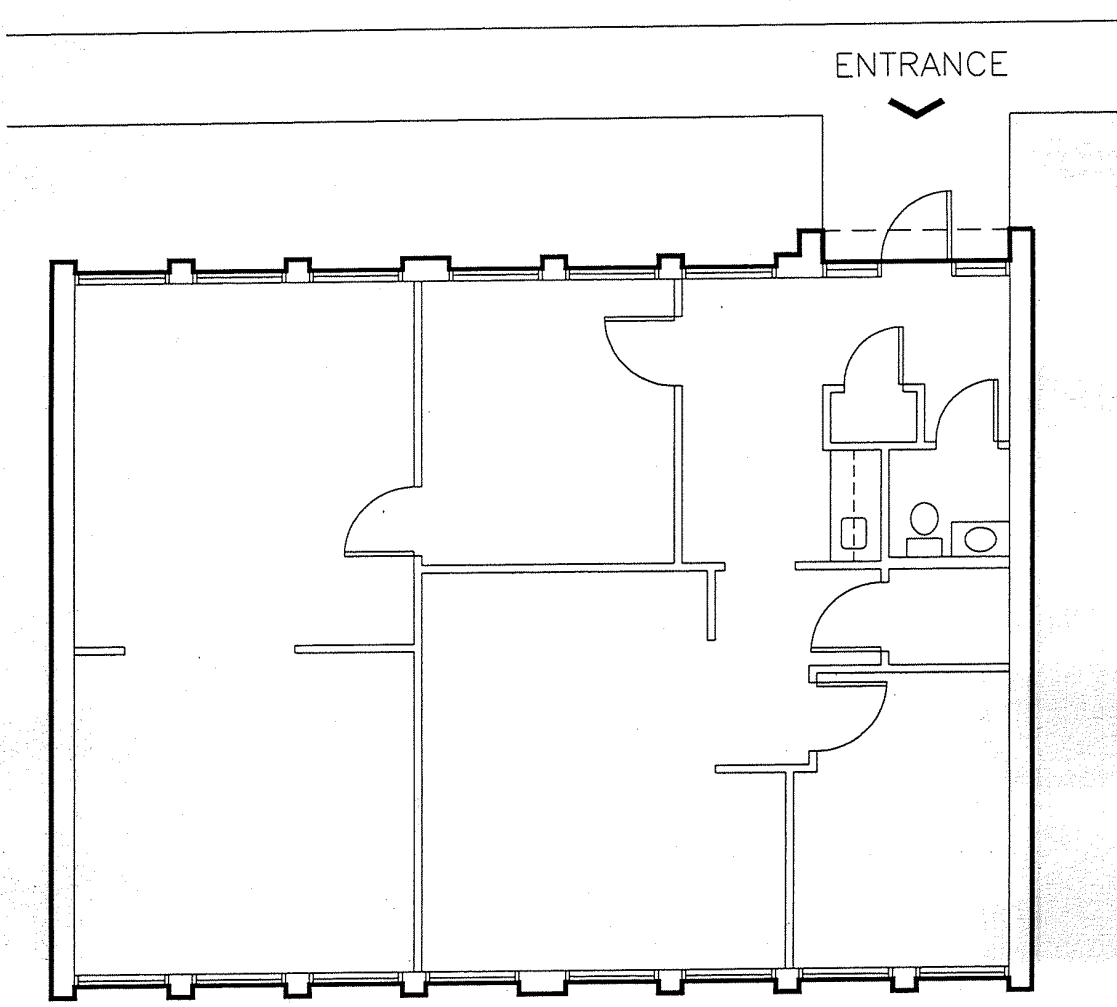

BUILDING D

1,344 SQ.FT.


0 1/8" 8'

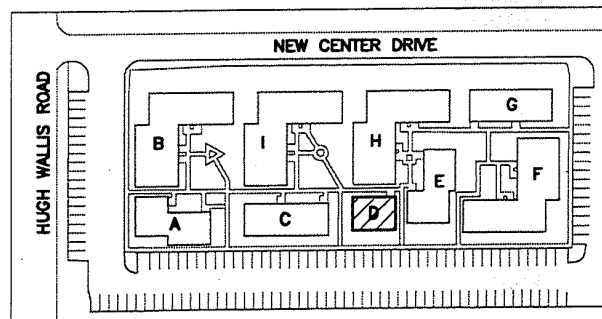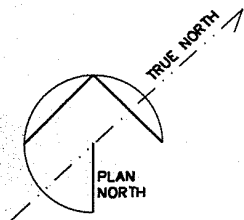

KEY PLAN


BUILDING D FLOOR PLAN

 <p>ZILER ARCHITECTS A PROFESSIONAL ARCHITECTURAL CORPORATION 101 CALICO BLVD LAFAYETTE, LOUISIANA 70503 337 269 6385 FAX 269 6380</p>	<p>RECORD DRAWINGS FOR:</p> <p>THE GARDENS</p> <p>1003 HUGH WALLIS ROAD LAFAYETTE, LOUISIANA</p>	<p>DATE ISSUED 10-12-06</p> <p>PROJECT NO. 2527</p> <p>SHEET NO. FP-D</p> <p>OF <u>9</u></p>
--	---	---

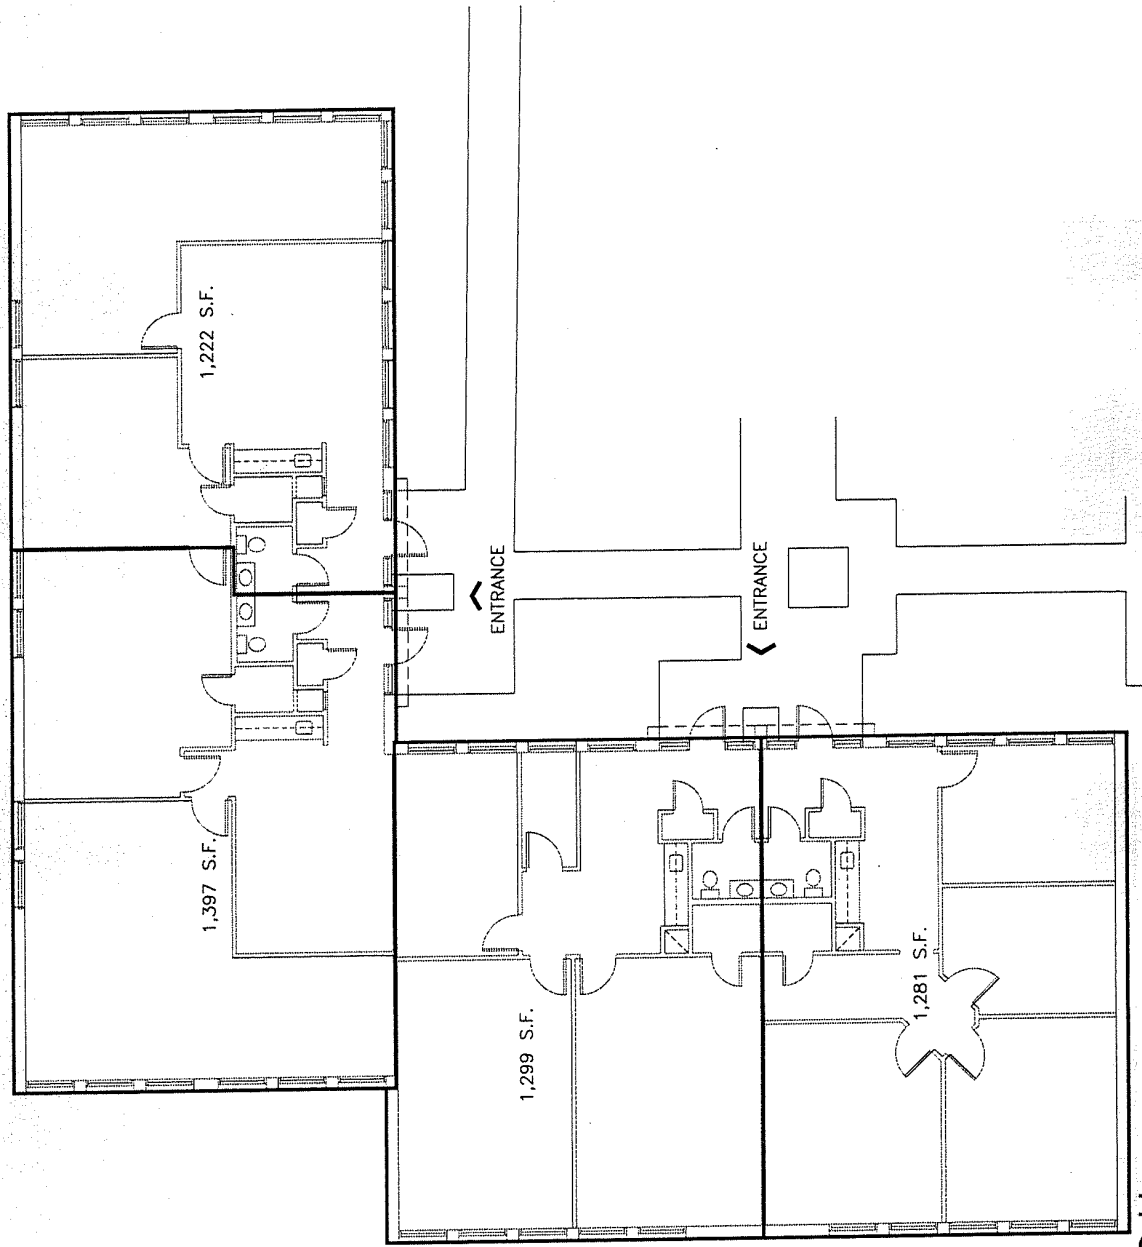

NTS



19 BUILDING H

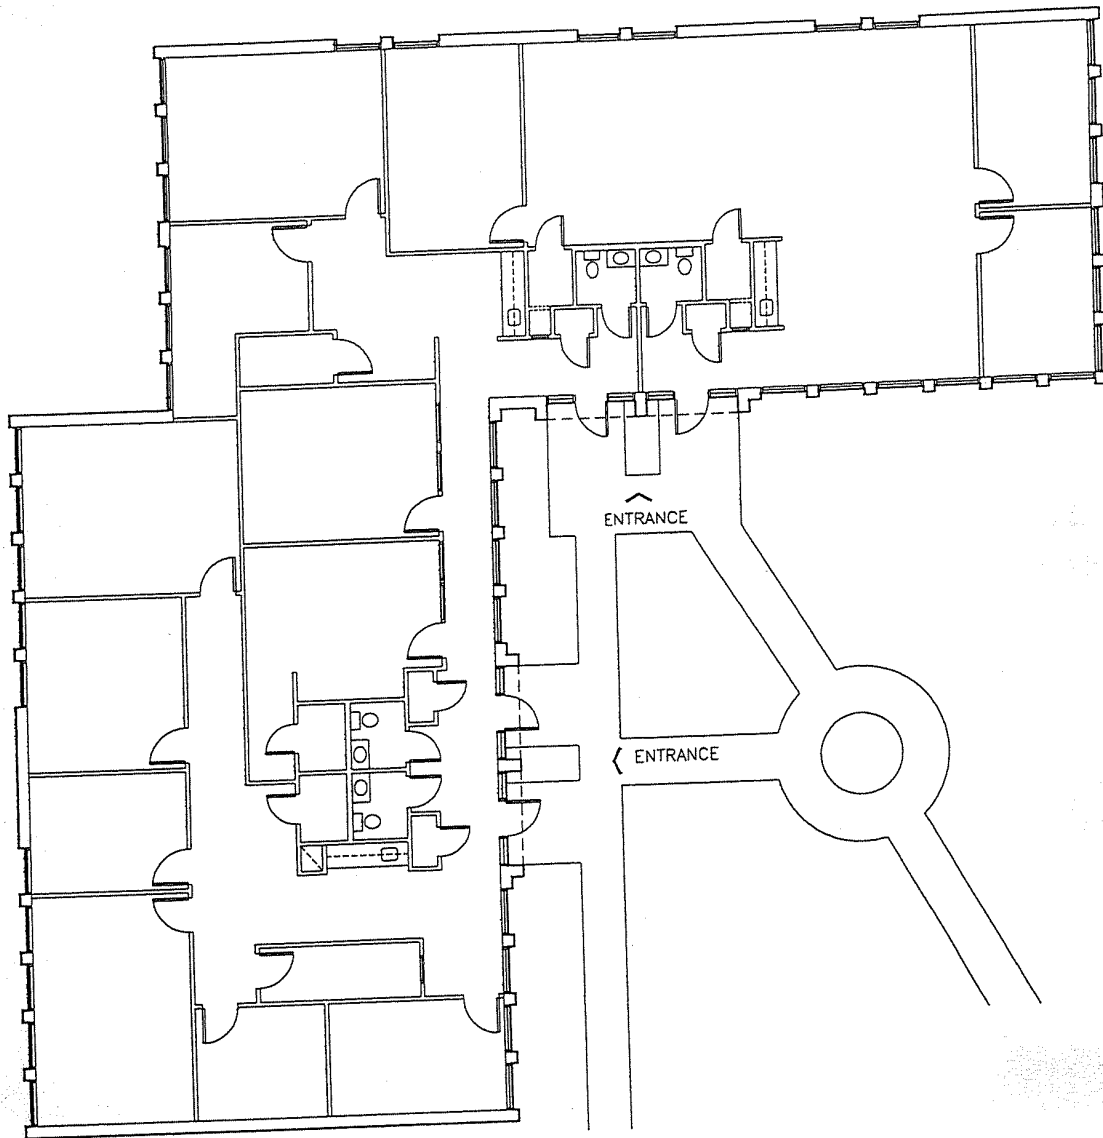

BUILDING I


5,199 SQ.FT.

0 1/16" 16'

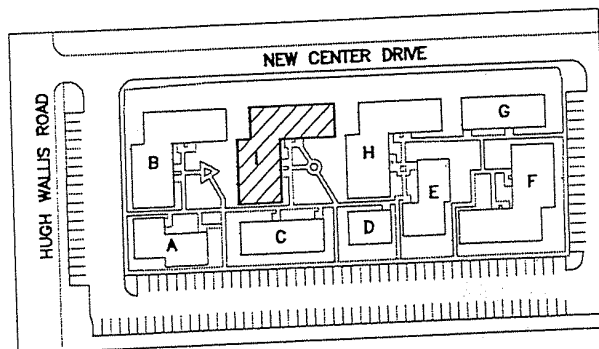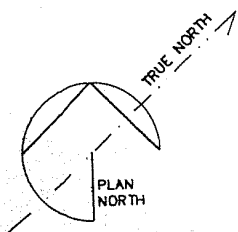

KEY PLAN

BUILDING I FLOOR PLAN

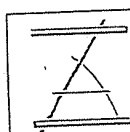

ZUER
ARCHITECTS
A PROFESSIONAL ARCHITECTURAL
CORPORATION
101 CALICO BLVD
LAFAYETTE, LOUISIANA 70503
337 269 6326 FAX 269 6380


RECORD DRAWINGS FOR:
THE GARDENS
1003 HUGH WALLIS ROAD
LAFAYETTE, LOUISIANA

DATE ISSUED
10-12-06

PROJECT NO.
2527

SHEET NO.
FP-1



OF 9

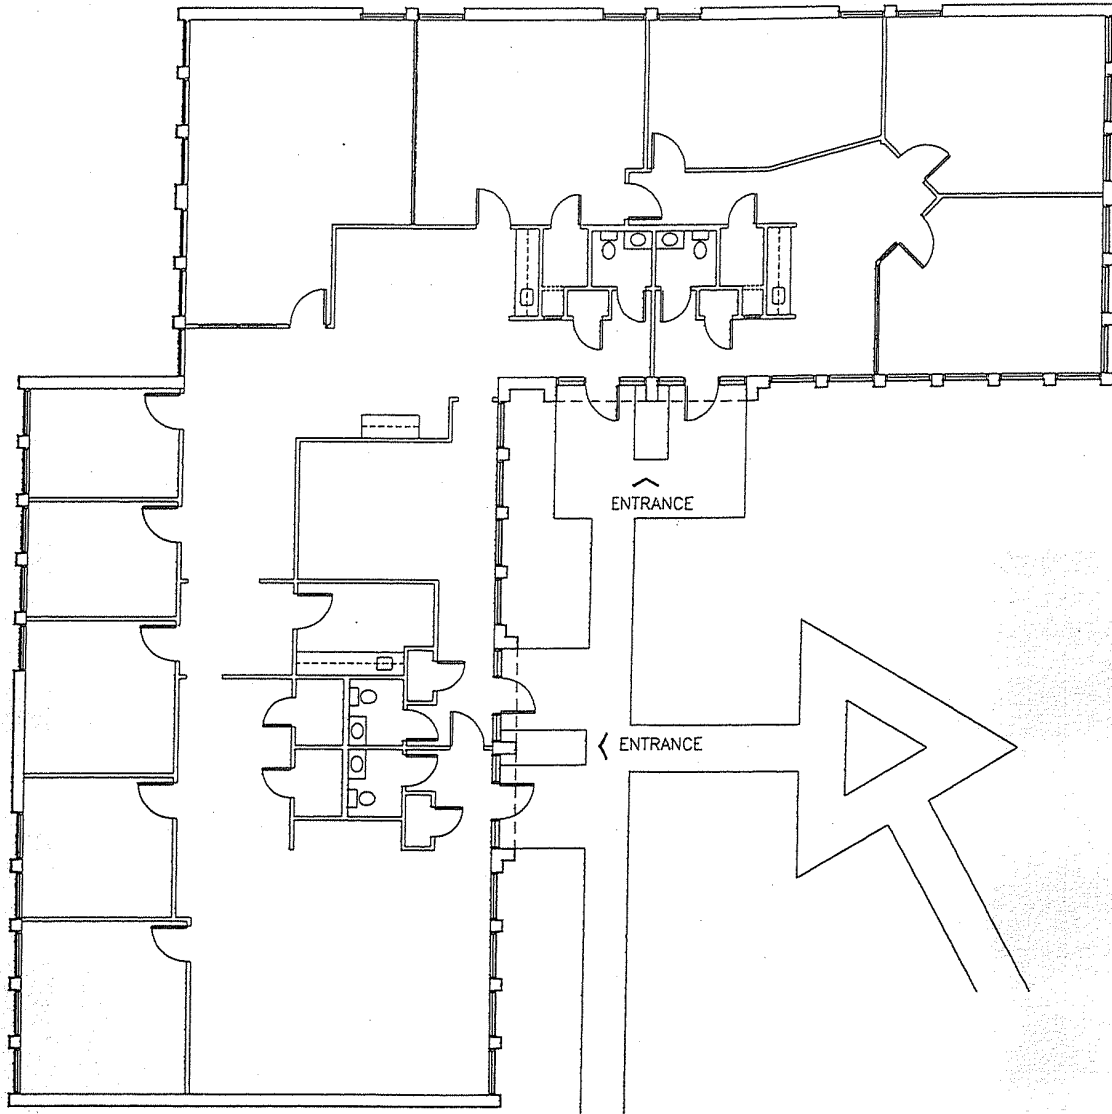

BUILDING B

5,199 SQ.FT.


0 1/16" 16'

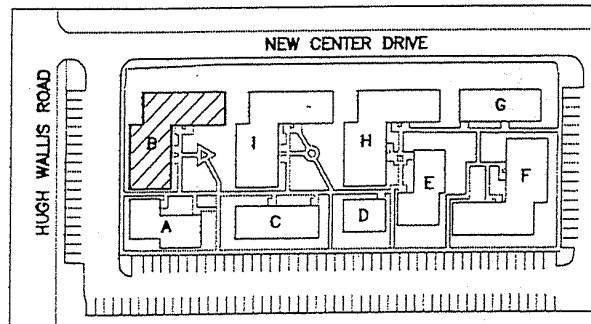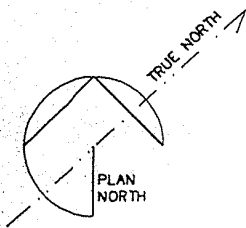

KEY PLAN

BUILDING B FLOOR PLAN



 <p>ZOLER ARCHITECTS A PROFESSIONAL ARCHITECTURAL CORPORATION 101 CALCO BLVD LAFAYETTE, LOUISIANA 70503 337 269 6326 FAX 269 6380</p>	<p>RECORD DRAWINGS FOR:</p> <p>THE GARDENS</p> <p>1003 HUGH WALLIS ROAD LAFAYETTE, LOUISIANA</p>	<p>DATE ISSUED 10-12-06</p> <p>PROJECT NO. 2527</p> <p>SHEET NO. FP-B</p> <p>OF <u>9</u></p>
---	---	---

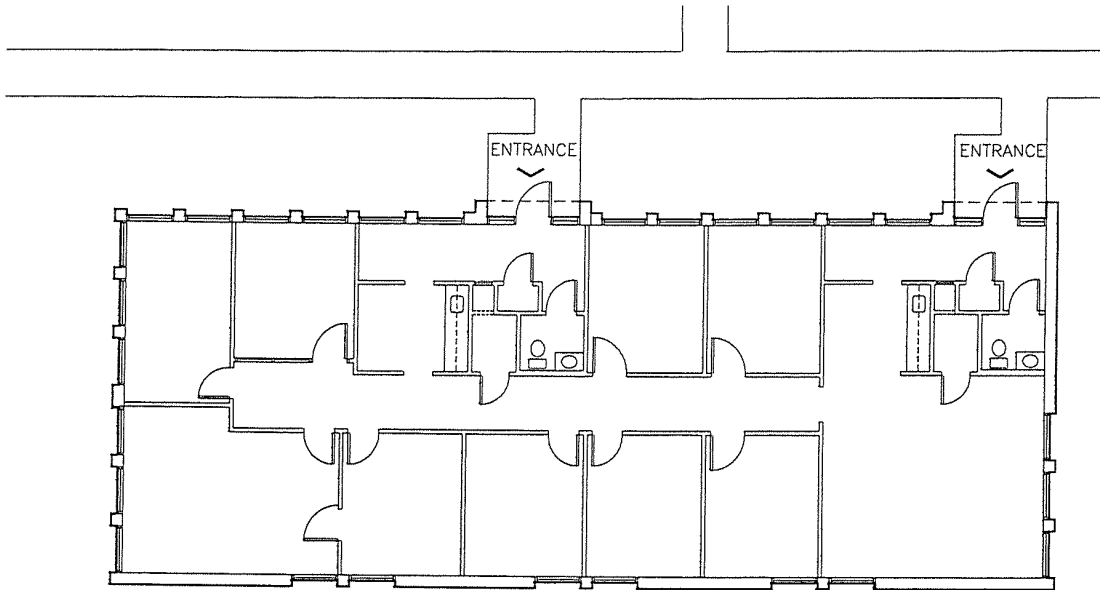

BUILDING C

2,624 SQ.FT.

0 1/16" 16'

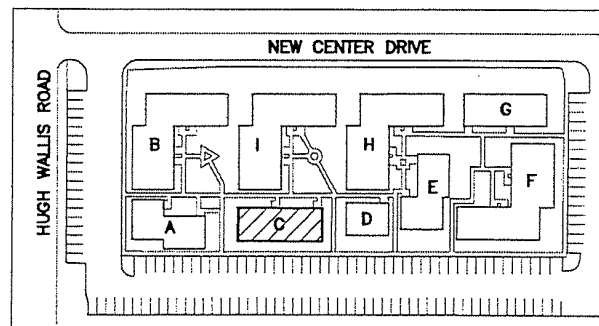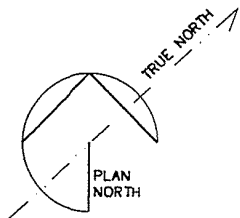

KEY PLAN

BUILDING C FLOOR PLAN

 <p>ZILER ARCHITECTS A PROFESSIONAL ARCHITECTURAL CORPORATION 101 CALCO BLVD LAFAYETTE, LOUISIANA 70503 337 269 6326 FAX 269 6360</p>	<p>RECORD DRAWINGS FOR:</p> <p>THE GARDENS</p> <p>1003 HUGH WALLIS ROAD LAFAYETTE, LOUISIANA</p>	<p>DATE ISSUED 10-12-06</p> <p>PROJECT NO. 2527</p> <p>SHEET NO. FP-C</p> <p>OF <u>9</u></p>
---	---	---